



CLIENT

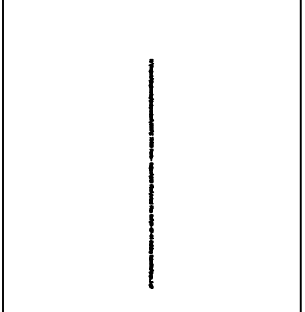

PINNACLE REAL ESTATE HOLDINGS, INC.
RIVERSIDE COUNTY TRAVEL ZONE LLC
COO & CO-FOUNDER

BRAND

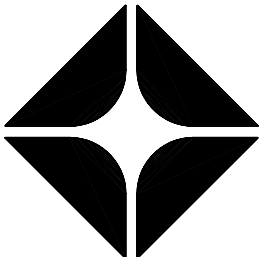

ARCO

BP WEST COAST PRODUCTS, LLC

CONSULTANT



Engineering & Construction, Inc.

733 N. MAIN ST.
ORANGE, CA 92686
714/ 769-2000
714/ 769-2002 Fax
www.wsecinc.com
A "Design/ Build" Co.


A "Design/ Build" Co.

A "Design/ Build" Co.

A "Design/ Build" Co.

NO.	DATE	REVISION DESCRIPTION
1	11-17-03	BUILDING SUBMITTAL
2	4-19-04	REVISED PER PLAN CHECK BUILDING SUBMITTAL
3	6-01-04	REVISED PER PLAN CHECK BUILDING SUBMITTAL
4	8-10-04	REVISED PER PLAN CHECK N-I-N-HOUSE CORRECTION
5	9-27-04	REVISED PER PLAN CHECK N-I-N-HOUSE CORRECTION
6	11-24-04	REVISED PER PLAN CHECK
7	10-20-05	COORDINATION CHECK

SEAL

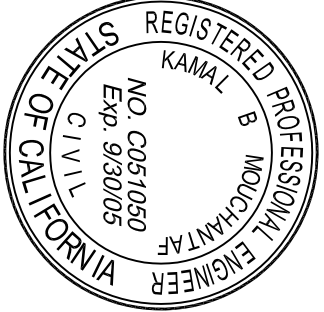

CONFIDENTIALITY STATEMENT:

THE REQUESTOR OF THESE MATERIALS UNDERSTANDS THAT COPIES OF THE MATERIALS REQUESTED ARE BEING COPIED AND COPIES OF THE MATERIALS CONTAIN PERMITTED AND PROHIBITED INFORMATION. THE REQUESTOR AGREES TO RETAIN THESE MATERIALS IN STRICT CONFIDENTIALITY AND AGREES NOT TO DISCLOSE THESE MATERIALS TO ANY OTHER PERSON OR ENTITY. THE REQUESTOR AGREES TO COVER THE MATERIALS WITH AN APPROPRIATE WARNING TO USE THE MATERIALS ONLY FOR THE LIMITED PURPOSE FOR WHICH THEY WERE MADE. THE MATERIALS REQUESTED ARE TO BE DESTROYED UPON COMPLETION OF THE INTENDED PURPOSE OR UPON THE REQUEST OF BP. WHOEVER DOES FIRST.

DEVELOPMENT INFORMATION

**NEW BUILD (STICK)
3600 SERIES AM/PM
CENTER CASHIER
TO GO DELI**

SITE ADDRESS:

23261 CAJALCO EXWY.
@ HARVILL AVENUE
PERRIS, California 92571

23261 CAJALCO EXWY.
@ HARVILL AVENUE
PERRIS, California 92571

23261 CAJALCO EXWY.
@ HARVILL AVENUE
PERRIS, California 92571


DESIGNED BY:	-	ALLIANCE Z&BOM:
CHECKED BY:	-	BP REPM:
DRAWN BY:	-	ALLIANCE PM:
VERSION:	V01	PROJECT NO:

DESIGNED BY:	-	ALLIANCE Z&BOM:
CHECKED BY:	-	BP REPM:
DRAWN BY:	-	ALLIANCE PM:
VERSION:	V01	PROJECT NO:


DRAWING TITLE:

BUILDING #1 SECTIONS


SHEET NO.

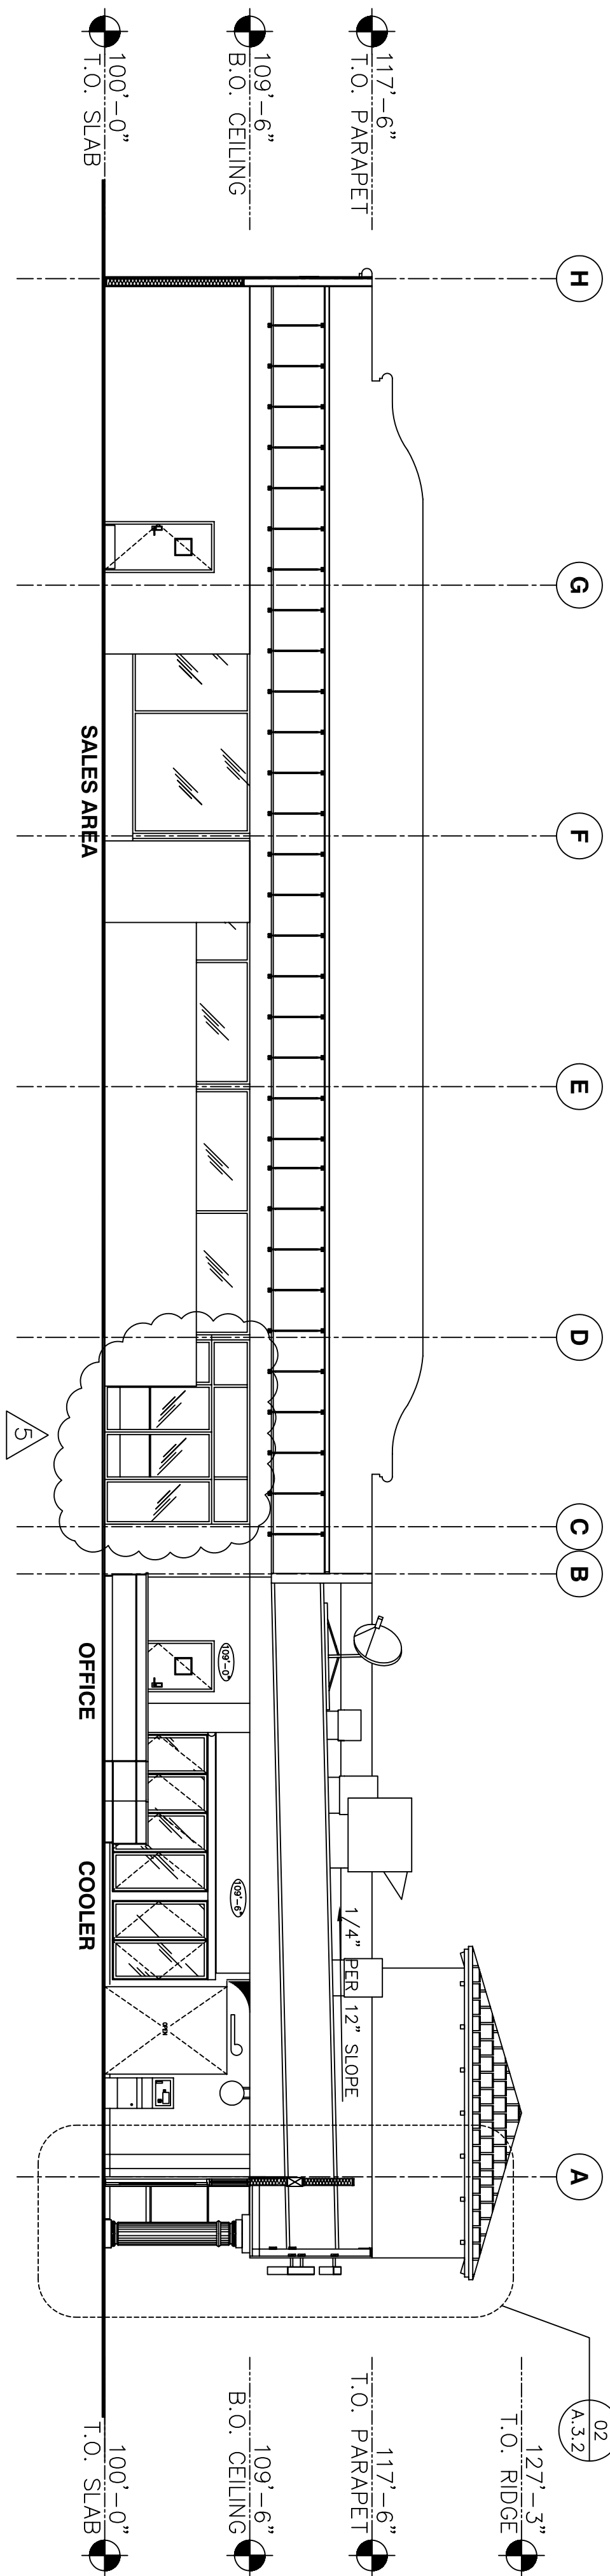

01 FRONT TO REAR BUILDING SECTION
A.3.1 SCALE: 1/4"=1'-0"

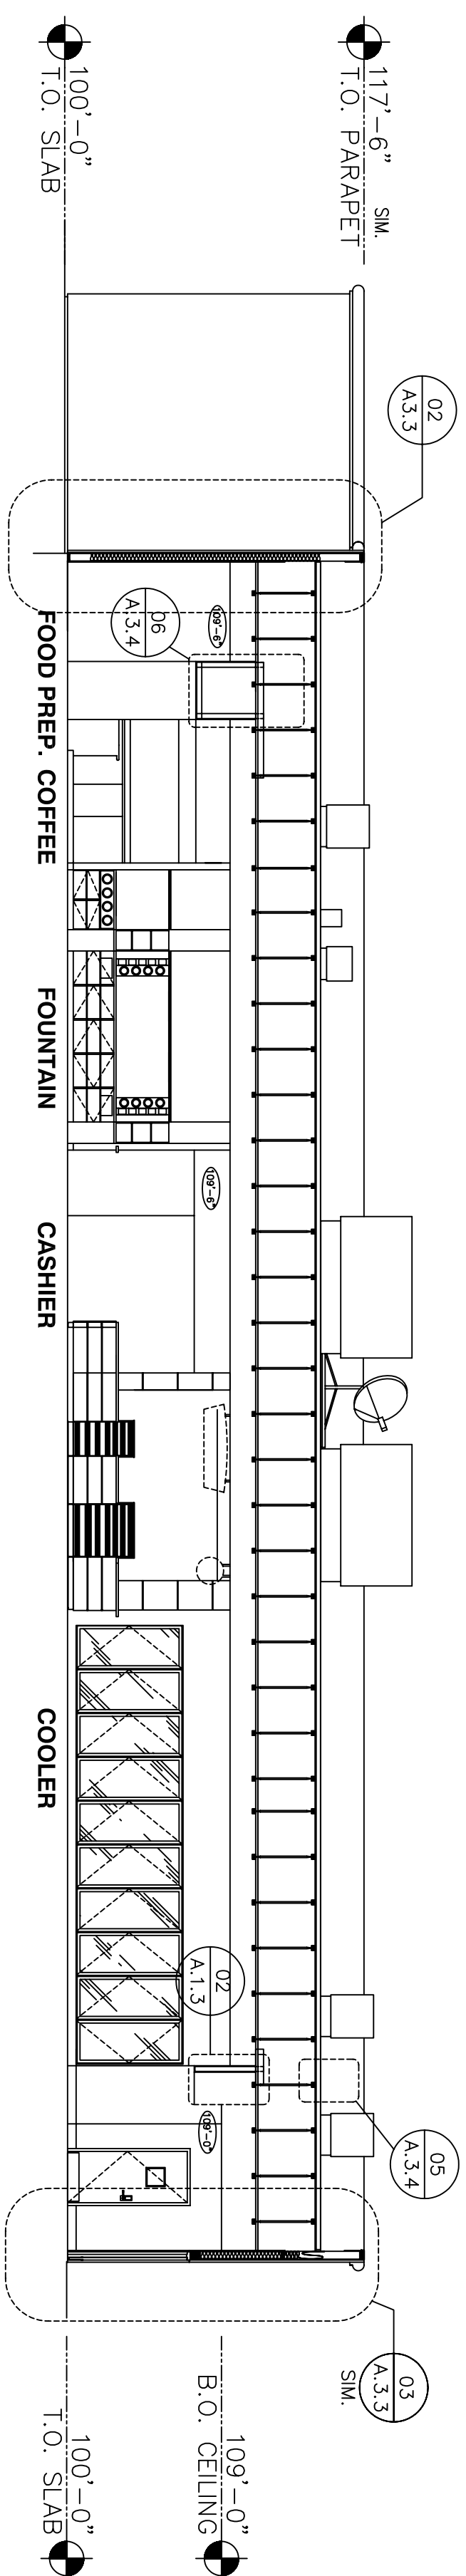

02 LEFT SIDE TO RIGHT SIDE BUILDING SECTION
A.3.1 SCALE: 1/4" = 1' - 0"

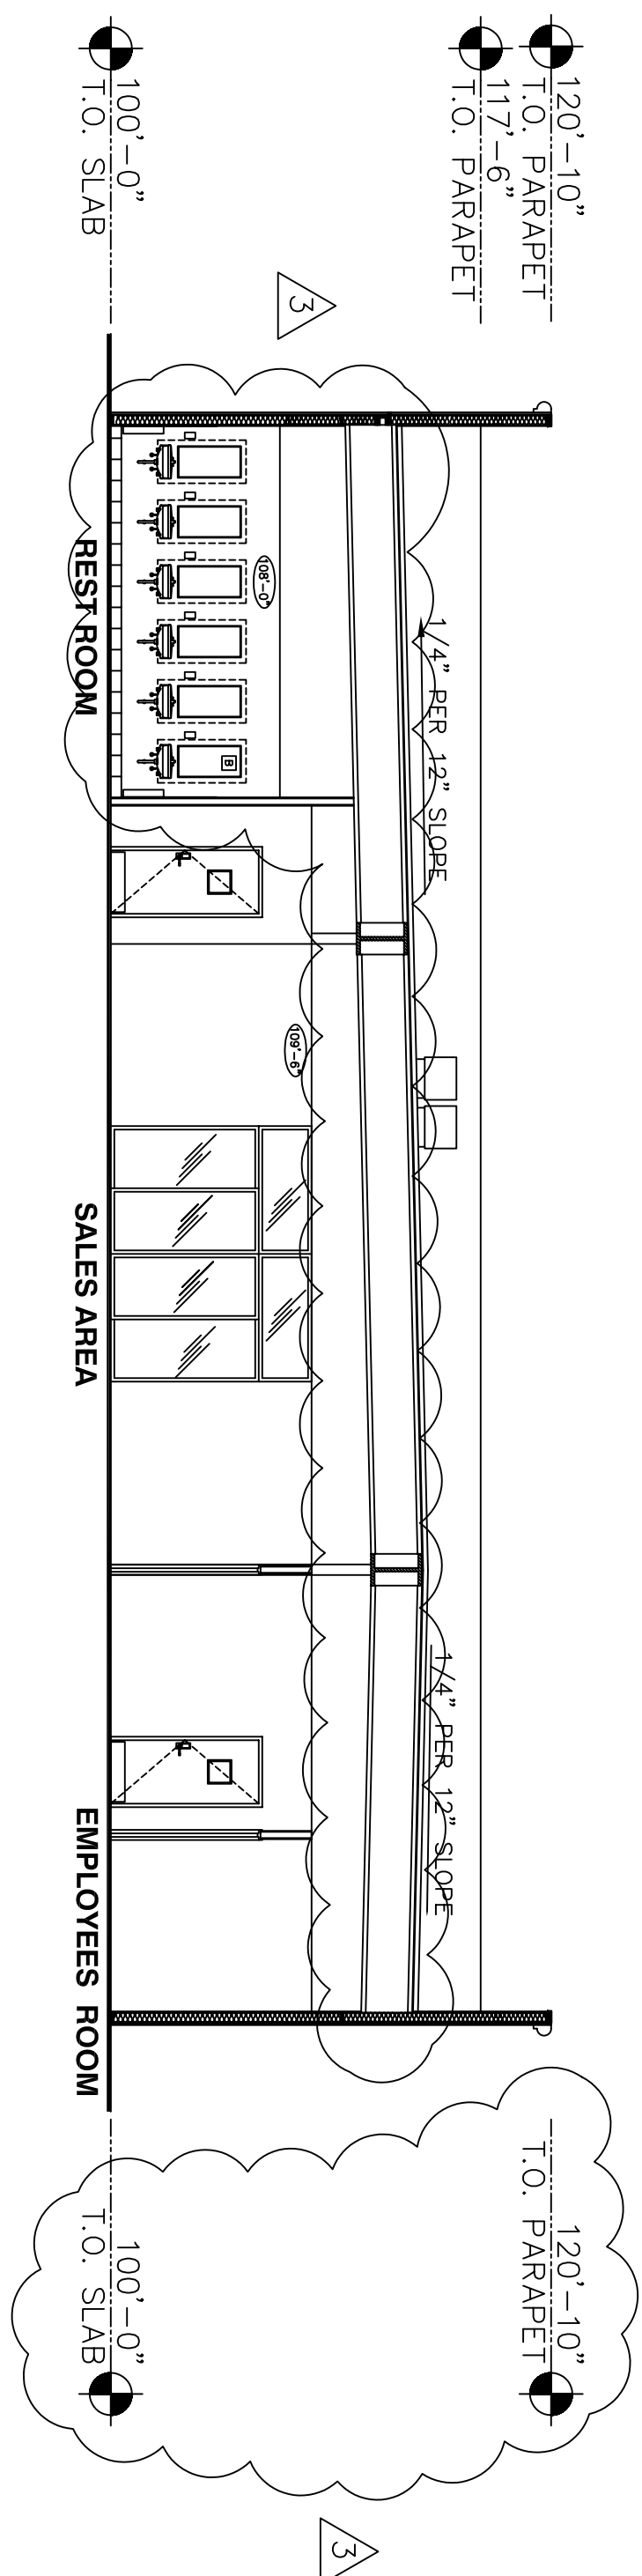

03
A.3.1 SCALE: 1/4"=1'-0"