


CLIENT:



PHINAC REAL ESTATE HOLDINGS, INC.
RIVERSIDE COUNTY TRAVEL ZONE LLC
COO & CO-FOUNDER

BRAND:

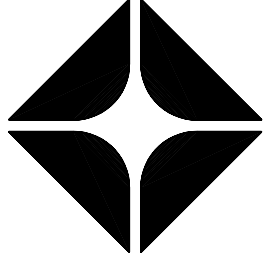

ARCO


BP WEST COAST PRODUCTS, LLC
CONSULTANT:

WESTERNSTATES
Engineering & Construction, Inc.

733 N. MAIN ST.
ORANGE, CA 92666
714/ 769-2000
714/ 769-2002 Fax
www.westernstatesinc.com
A "Design/Build" Co.

NO.	DATE	REVISION DESCRIPTION
1	11-17-03	BUILDING SUBMITTAL
2	4-19-04	REVISED PER PLAN CHECKS
3	6-01-04	REVISED PER PLAN CHECKS
4	8-10-04	REVISED PER PLAN CHECKS
5	9-27-04	REVISED PER PLAN CHECKS & N-1-HOUSE CORRECTIONS

SEAL:

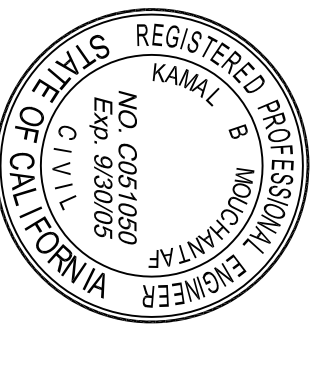

THE SIGNATURE OF THIS MATERIAL REPRESENTS THAT I AM A LICENSED PROFESSIONAL ENGINEER AND THAT THE DESIGN IS CORRECT AND COMPLETE AND THAT THE DESIGN IS IN ACCORDANCE WITH ALL APPLICABLE CODES AND STANDARDS. I AM NOT PROVIDING ANY GUARANTEE OR WARRANTY FOR THE DESIGN OR THE CONSTRUCTION OF THE PROJECT. THE DESIGN IS THE PROPERTY OF THE ENGINEER AND SHALL REMAIN THE PROPERTY OF THE ENGINEER. THE DESIGN IS NOT TO BE USED FOR ANY OTHER PROJECT WITHOUT THE WRITTEN PERMISSION OF THE ENGINEER.

NEW BUILD (STICK)
3600 SERIES AM/PM
CENTER CASHIER
TO GO DELI

SITE ADDRESS:
23261 CALALCO EXWY.
@ MARILL AVENUE
FERRIS, CALIFORNIA 92571

DESIGNED BY: • ALLIANCE TEAM
CHECKED BY: • BP BEYNE
DRAWN BY: • ALLIANCE PM
VERSION: • V01
PROJECT NO: 11.17.03
E75403

BUILDING # 1
SALES COUNTER
MILLWORK


DOFO
F.5.4

NOTES:

SALES COUNTER TO BE CLAD WITH PLASTIC LAMINATE
PLYWOOD PER FINISH SCHEDULE.
METAL SALES COUNTER SHOWN CAN BE SUBSTITUTED
WITH WOOD FRAMING AT DIMENSIONS SPECIFIED.
PLYWOOD VENEER IS LAYERED TO CREATE 1/2" REVEAL.
REFER TO VENEER DETAIL.
AT SECTIONS WITH WIRE SHELVES, SMOOTH PANELS TO
RECEIVE ONLY LAMINATE. FOR WIRE SHELF CLEARANCE,
FIELD VERIFY DIMENSIONS PRIOR TO FABRICATION


LAMINATES

- SS-1 COUNTER TOP: GIBBALTER "BEEG TIMEWEST" (150-TM)
BY: WILSONART
USE 0125 SOLID SURFACE LAMINATE AT PANPOINTS
- SS-2 COUNTER TOP: 18 GAUGE STAINLESS STEEL
- L-1 WOOD LAMINATE: "FUSION MAPLE" (7909-60)
BY: WILSONART
- L-2 METAL LAMINATE: "CREC" WITH CUSTOM FINISH (992160)
BY: WILSONART
- L-3 COLOR LAMINATE: "BLUE" (1025)
BY: ABBETT LAMINATI

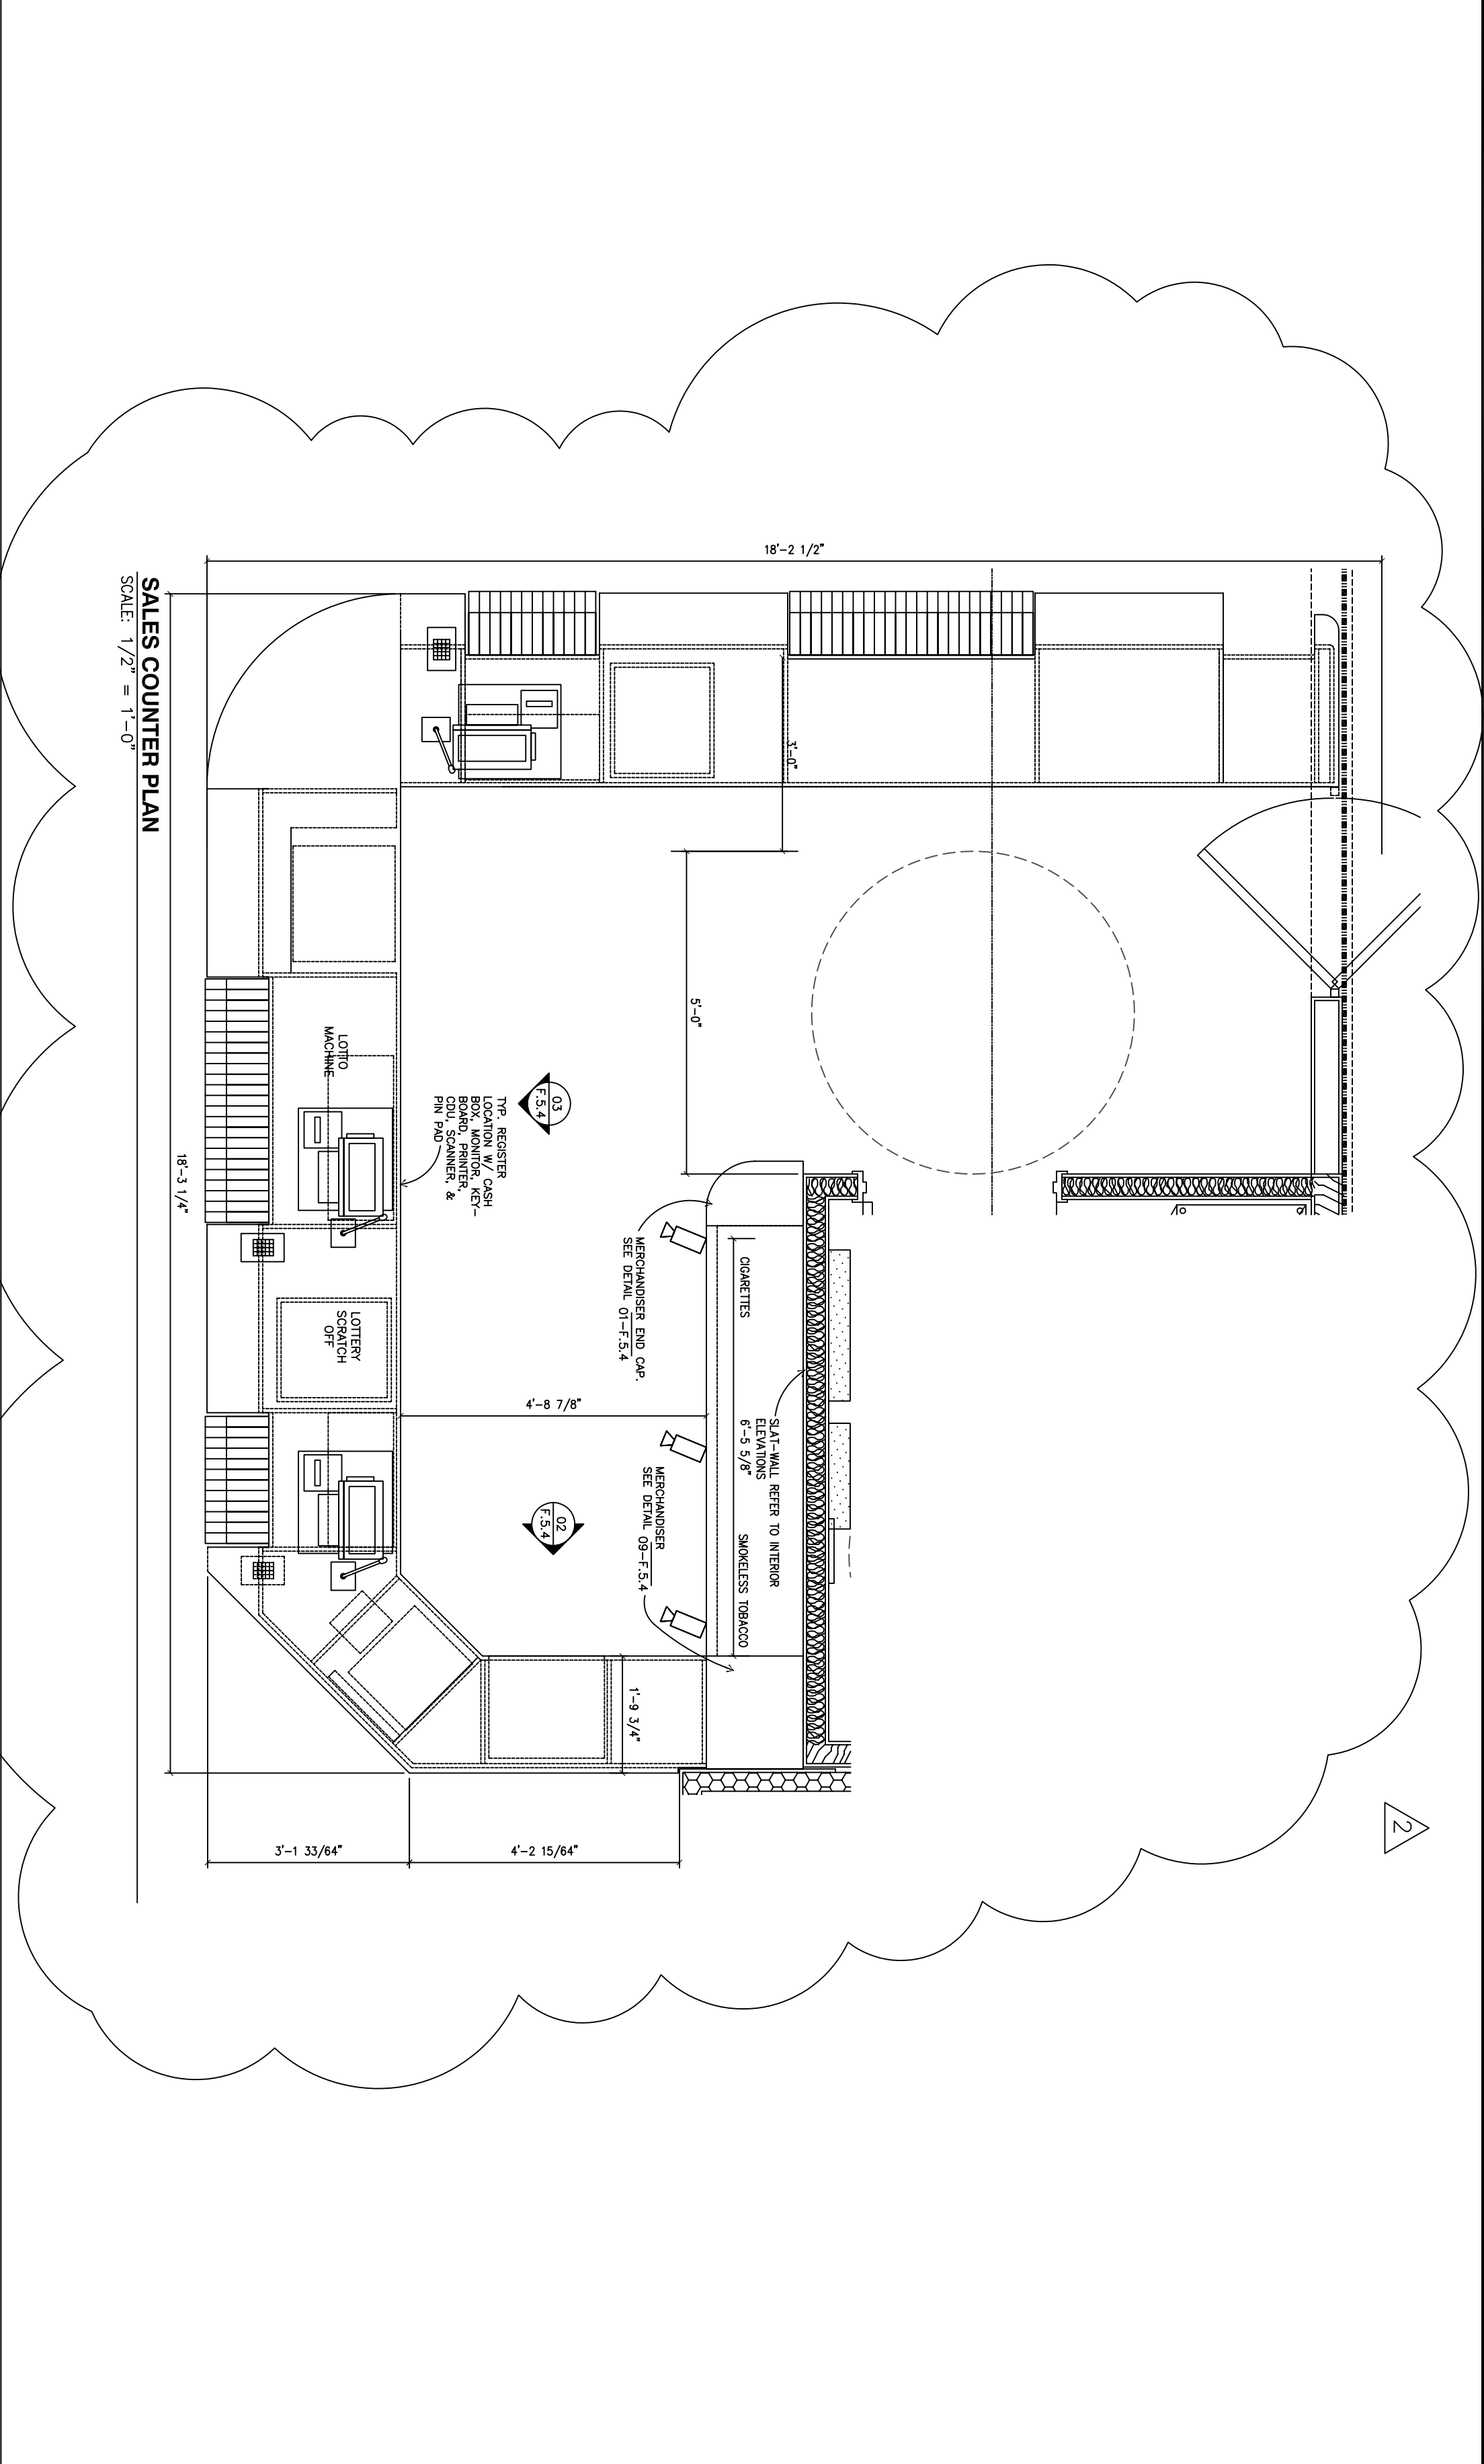


SALES COUNTER PLAN
SCALE: 1/2" = 1'-0"


01 MERCHANDISER PLAN
PLYWOOD PLATE
F.5.4 SCALE: 3/4" = 1'-0"

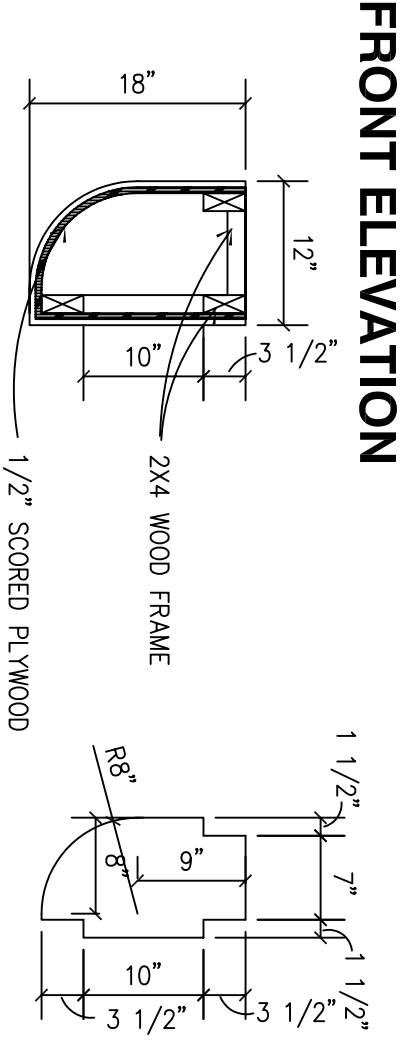


FRONT ELEVATION

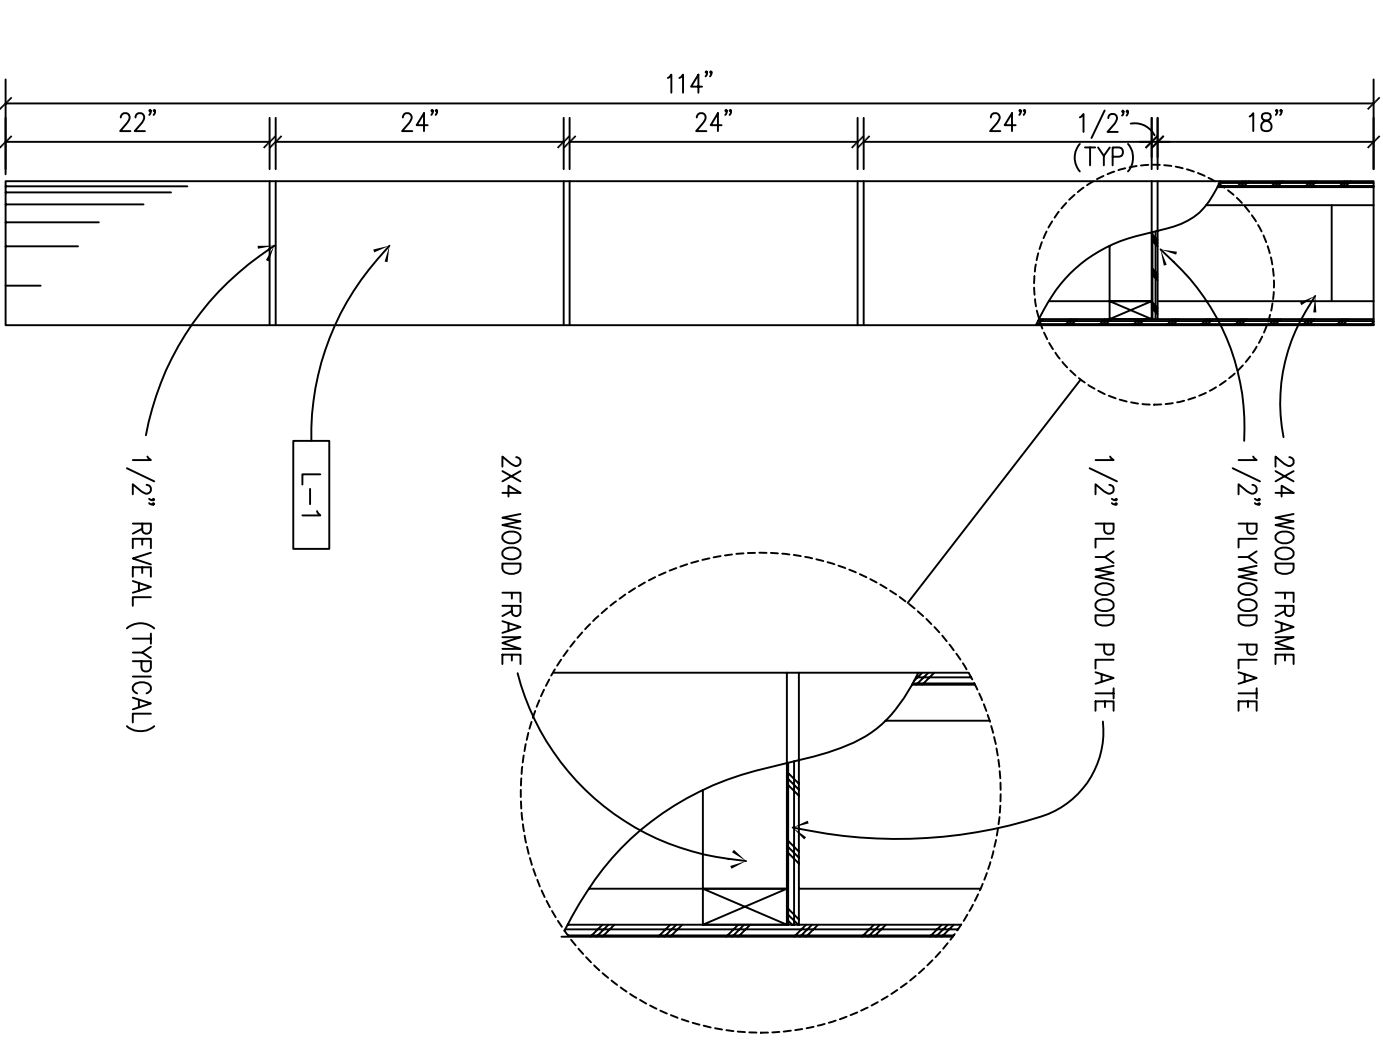


02 SALES COUNTER ELEVATION
F.5.4 SCALE: 3/4" = 1'-0"

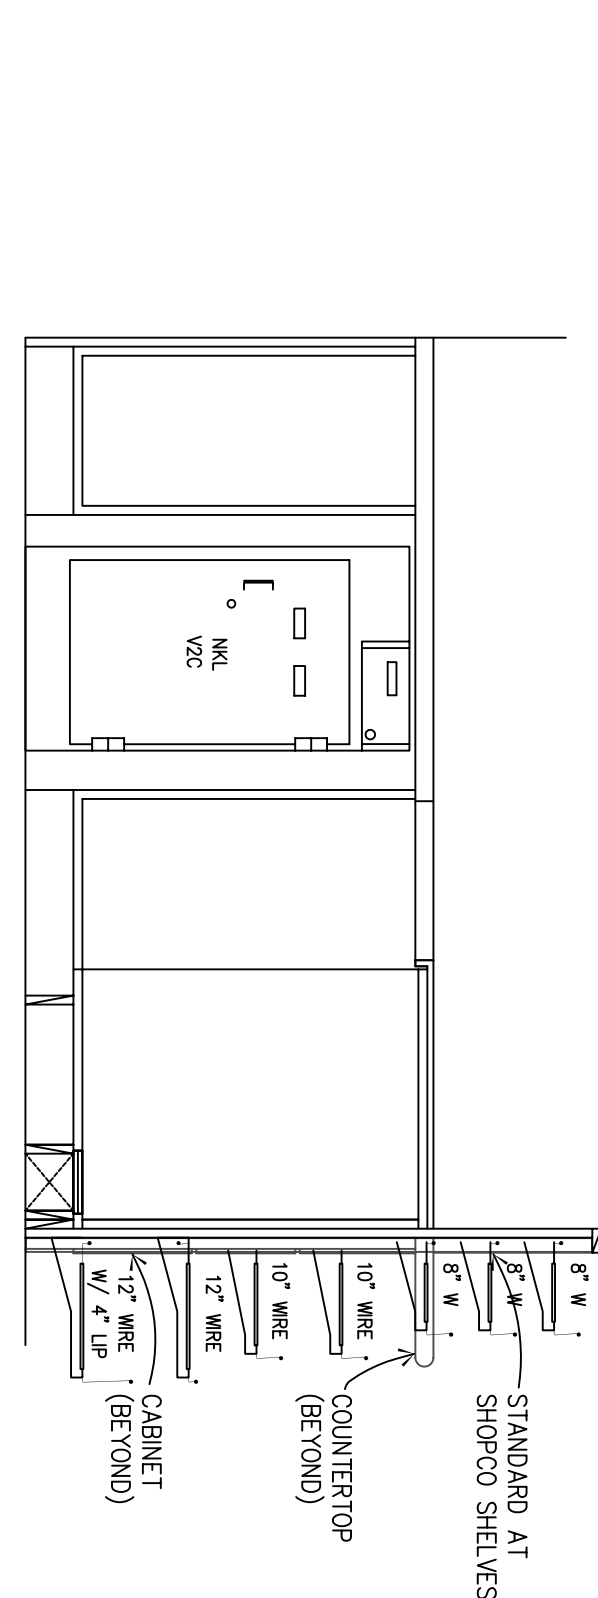


03 SALES COUNTER ELEVATION
F.5.4 SCALE: 3/4" = 1'-0"

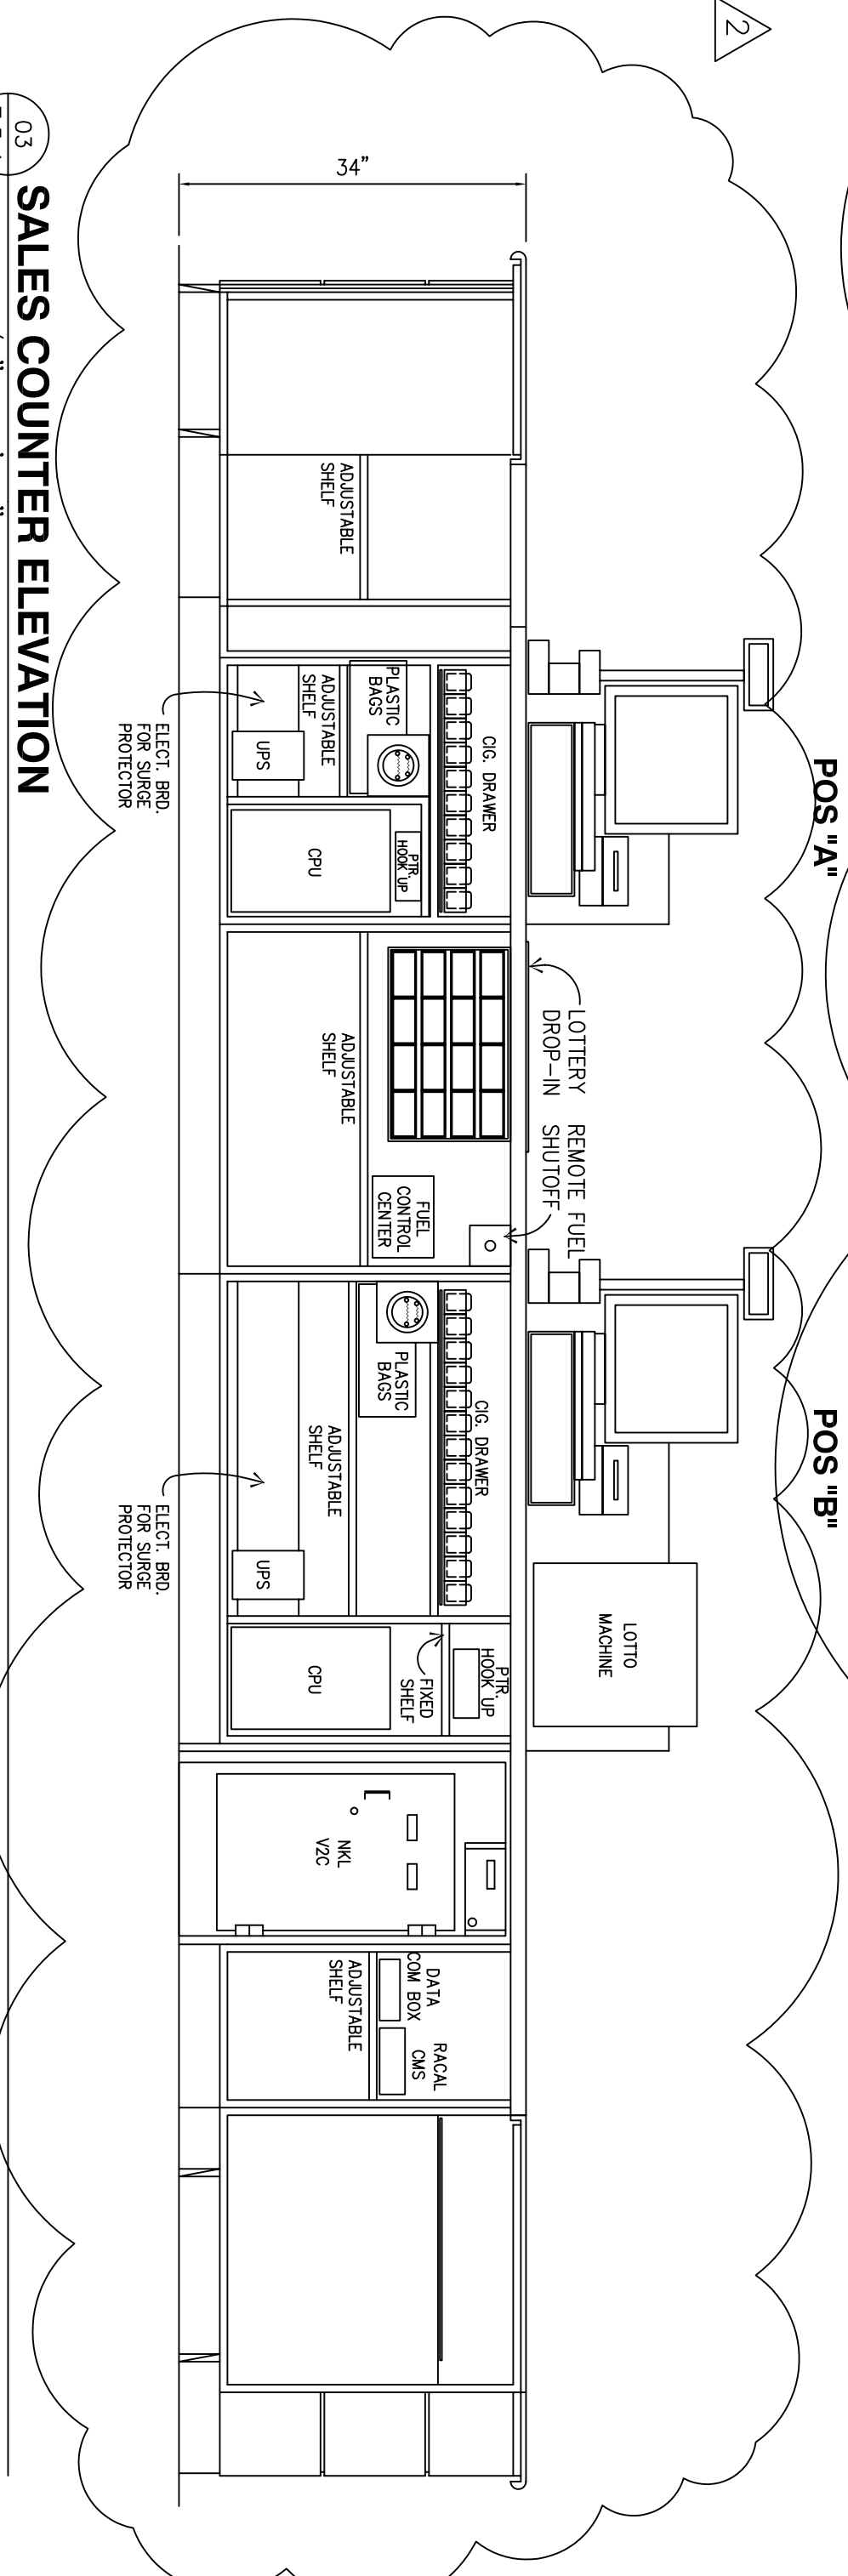


04 VERTICAL FRONT
F.5.4 SCALE: 3/4" = 1'-0"

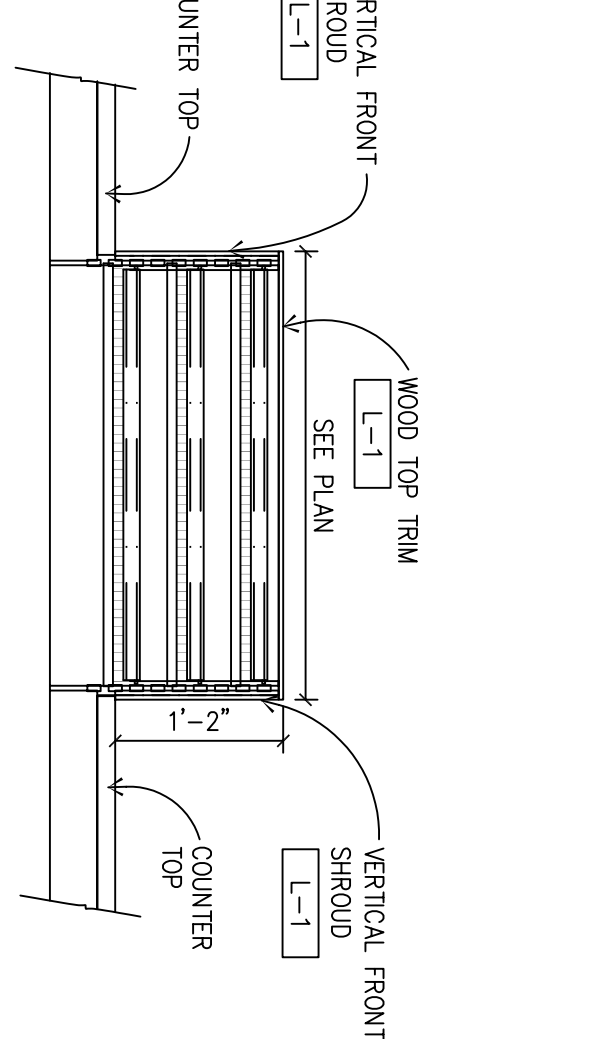


05 VERTICAL FRONT SECTION
F.5.4 SCALE: 3/4" = 1'-0"

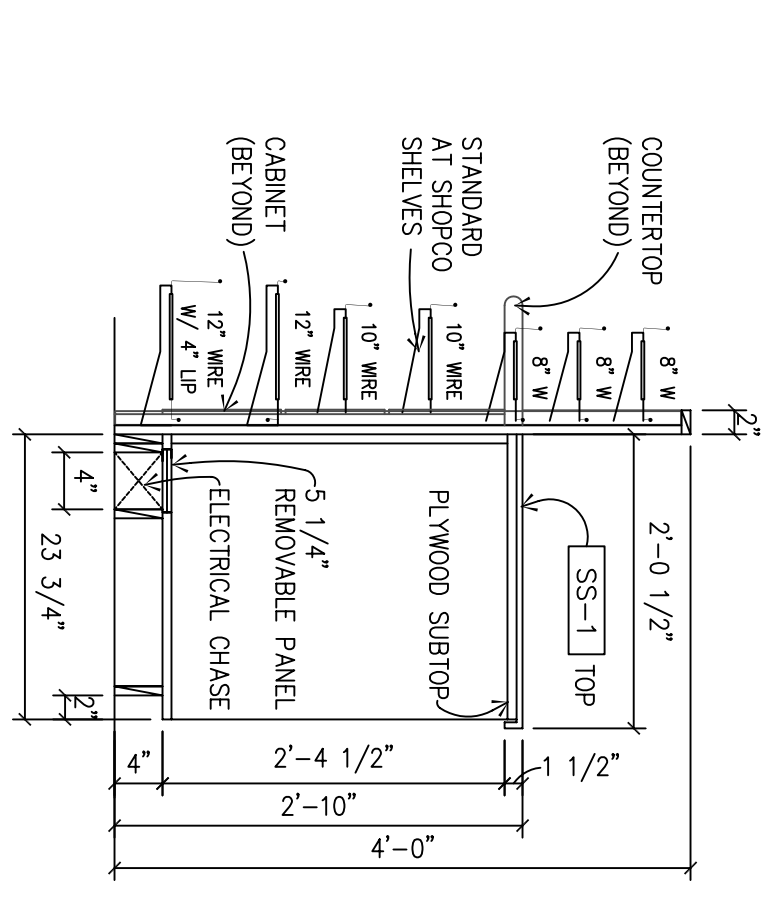


06 EXTENDED TOP SECTION (TYP.)
F.5.4 SCALE: 3/4" = 1'-0"

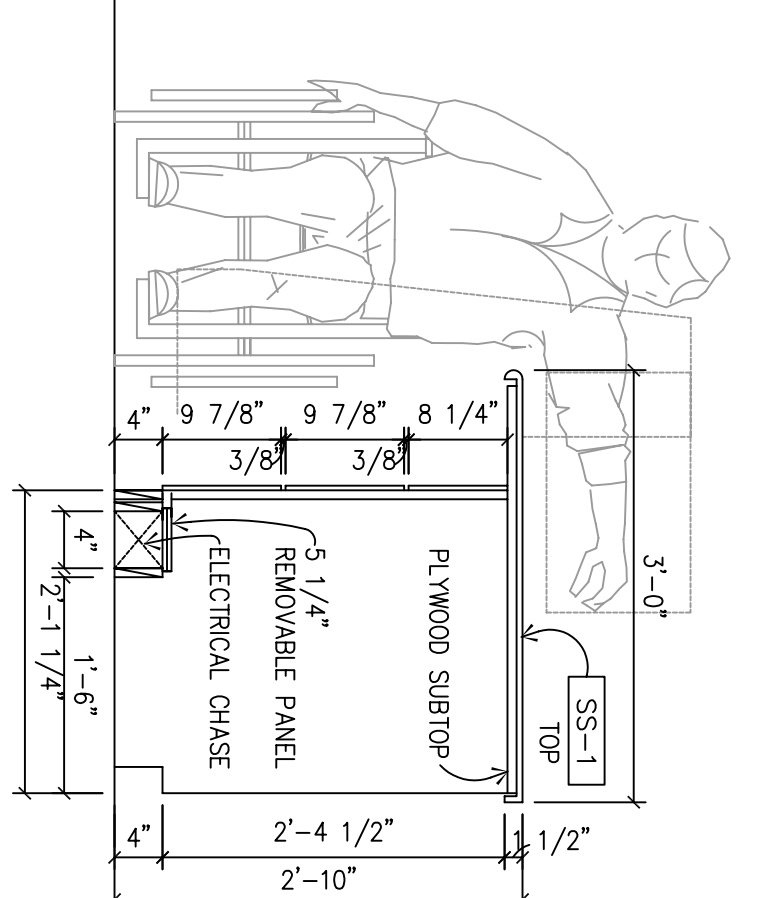

07 VERTICAL FRONT SECTION (TYP.)
F.5.4 SCALE: 3/4" = 1'-0"

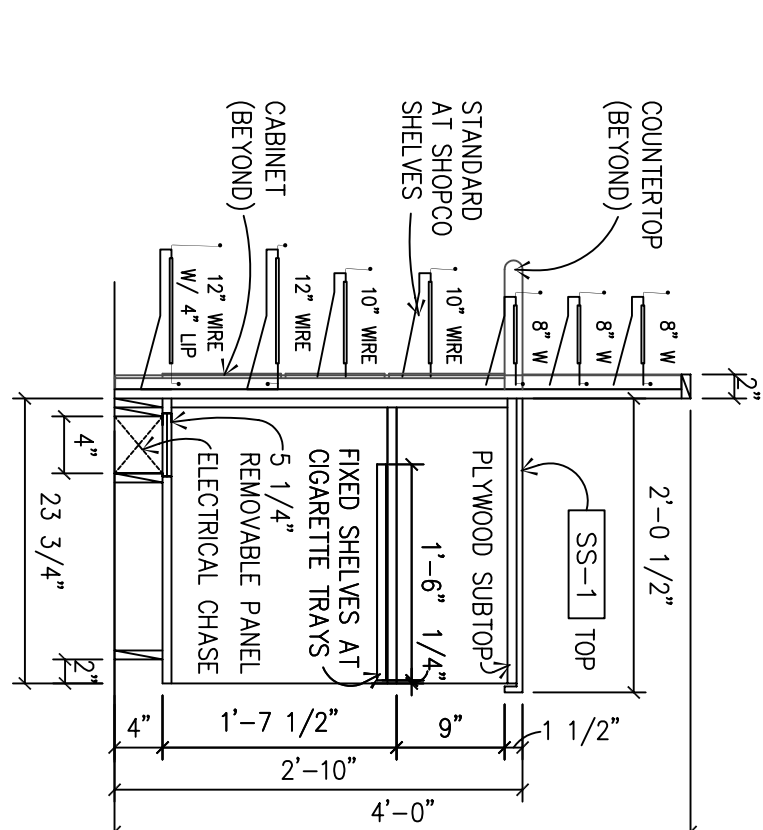

08 EXTENDED TOP SECTION
F.5.4 SCALE: 3/4" = 1'-0"

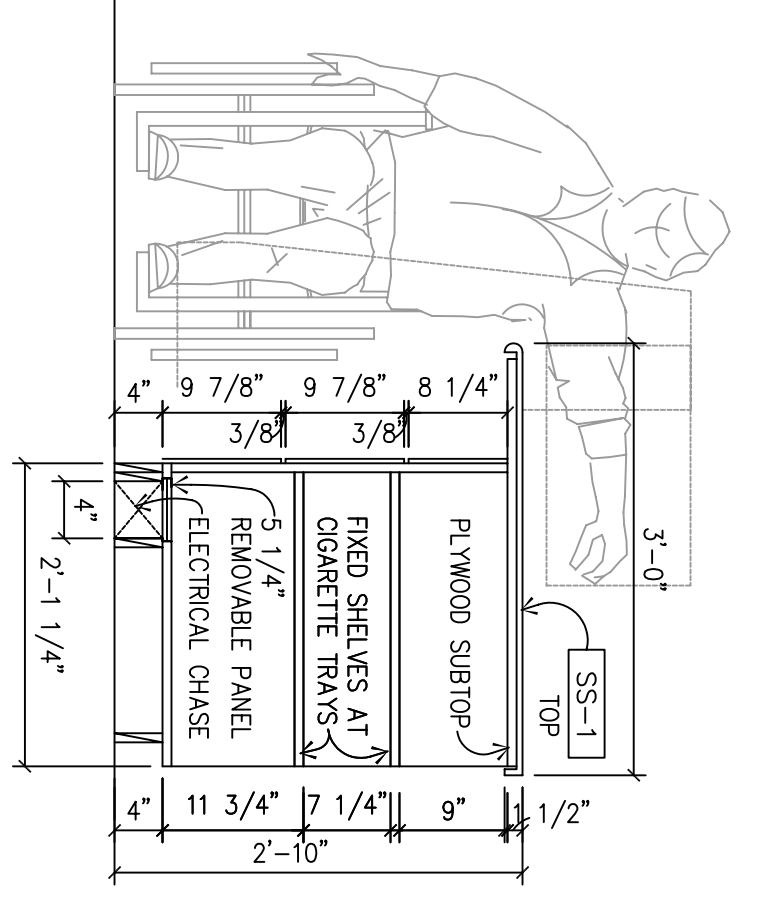

09 MERCHANDISER DETAIL
F.5.4 SCALE: 3/4" = 1'-0"

