GENERAL NOTES:

A. TRANSITIONS FROM ONE ROOM TO ANOTHER SHALL BE DONE UNDER CENTER OF DOORS WHERE POSSIBLE
B. WALL BASE, REFER TO INTERIOR ELEVATIONS

KEYED NOTES:

1. FLOORING TILE TO BE CUT AT BACK OF THRESHOLD
2. THRESHOLD
3. CENTER TILE PATTERN IN REST ROOMS
4. 4" PREMANUFACTURED FREEZER FLOOR.
5. HOLD FLOOR FINISH FROM WALL AT COUNTERS. PROVIDE SHIMS FOR MILLWORK AS REQUIRED.
6. FLOOR DRAINS, SLOPE FLOOR AS SHOWN BY TILE INSTALLER
7. RAISED PLATFORM. SEE DETAIL 03–A.1.2 AND 04–A.1.2

FLOOR FINISH

CONCRETE

CON–1 SMOOTH MACHINE TROWELLED FINISH
COATING: BENJAMIN MOORE
SILICONE ACRYLIC CLEAR SEALER 078–00

CERAMIC TILE

T–1 COLOR: ROCKY MOUNTAIN SERIES BIANCO (801)
BY: DALTILE
GROUT: 1/4" SAND (96) BY MAPEI

T–2 COLOR: ROCKY MOUNTAIN SERIES BEIGE (803)
BY: DALTILE
GROUT: 1/4" SAND (96) BY MAPEI

QUARRY TILE

QT–1 COLOR: RED SURETREAD (Q81)
USE RED PAVER (Q84) UNDER EQUIPMENT
BY: DALTILE
GROUT: 1/4" GRAY (09) BY MAPEI

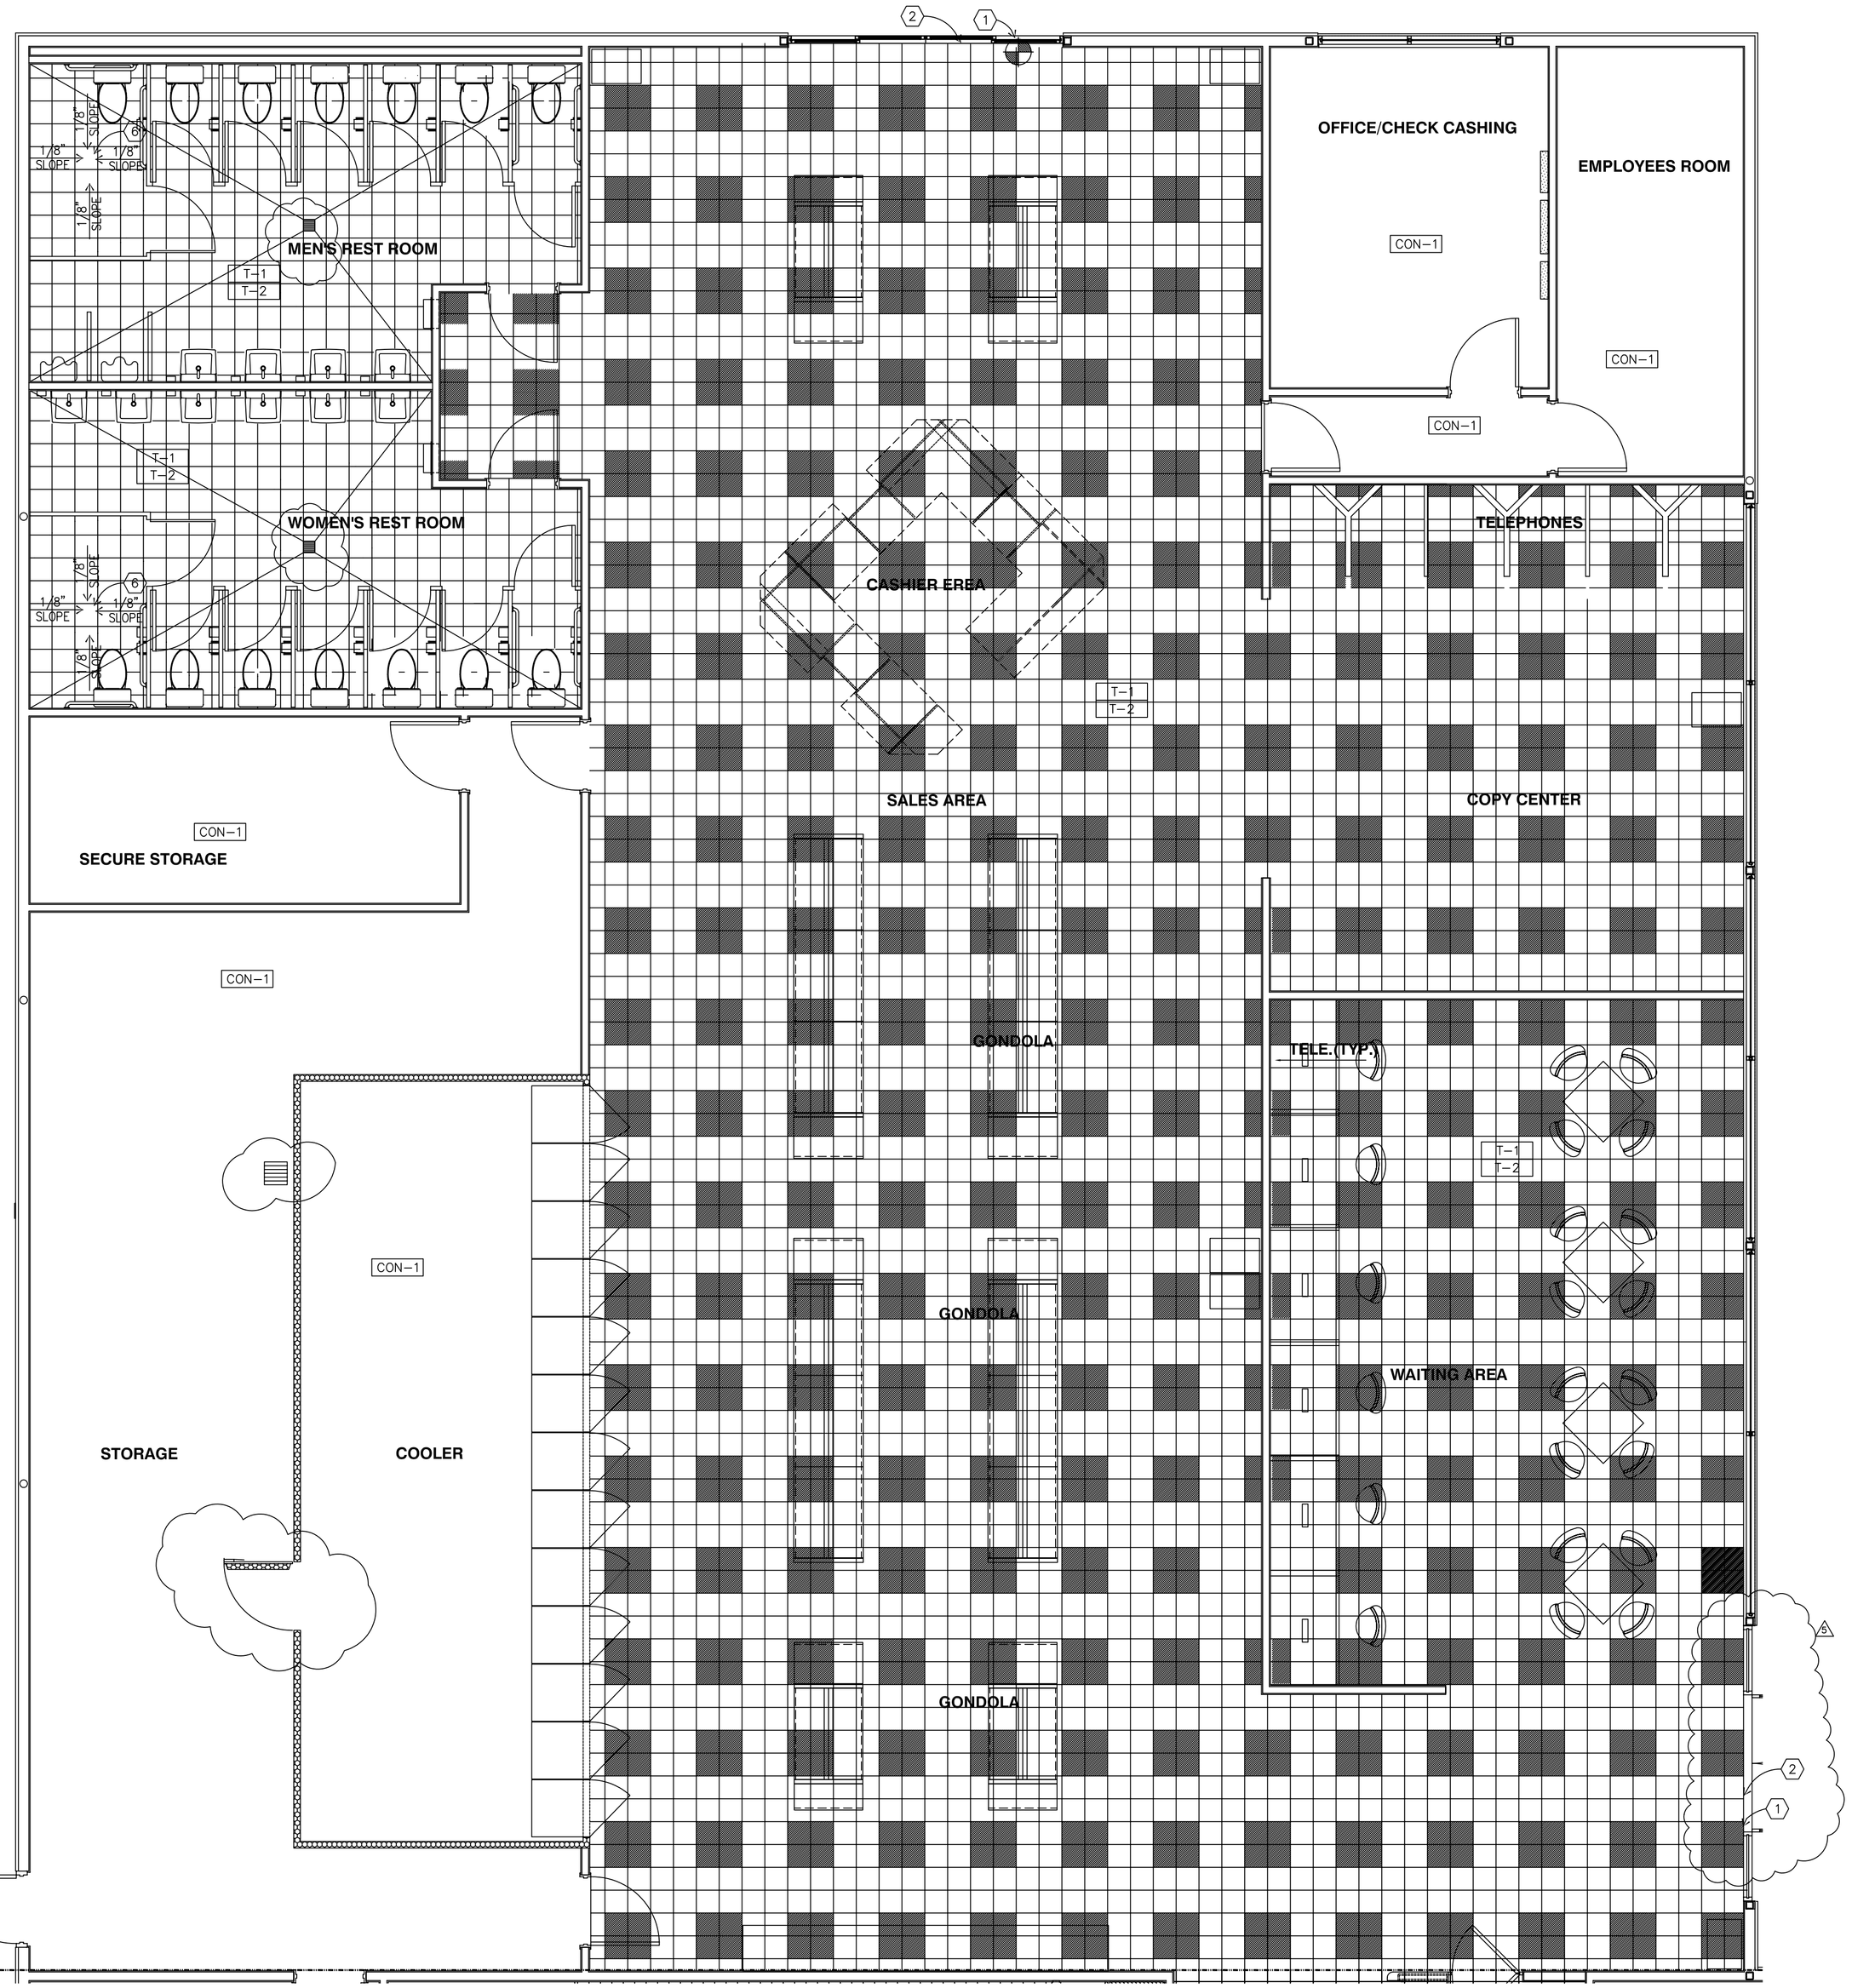

FLOOR FINISH PLAN

SCALE: 1/4" = 1'–0"

0 2 4 6
SCALE: 1/4" = 1'-0"

Survey North

CLIENT:

PINNACLE REAL ESTATE HOLDINGS, INC.
RIVERSIDE COUNTY TRAVEL ZONE LLC
COO & CO-FOUNDER

BRAND:

ARCO
BP WEST COAST PRODUCTS, LLC

CONSULTANT:

WESTERN STATES
Engineering & Construction, Inc.
733 N. MAIN ST
ORANGE, CA 92867
714/769-2000
714/769-2002 Fax
www.wsecinc.com
A Design Build Co.

NO.	DATE	REVISION DESCRIPTION
1	11–17–03	BUILDING SUBMITTAL
2	4–19–04	REVISED PER PLAN CHECK & IN–HOUSE CORRECTIONS BUILDING SUBMITTAL
3	6–01–04	REVISED PER PLAN CHECK & IN–HOUSE CORRECTIONS BUILDING SUBMITTAL
4	8–10–04	REVISED PER PLAN CHECK & IN–HOUSE CORRECTIONS
5	9–27–04	REVISED PER PLAN CHECK & IN–HOUSE CORRECTIONS
6	11–24–04	REVISED PER PLAN CHECK
7	X–XX–05	COORDINATION CHECK

SEAL:

REGISTERED PROFESSIONAL ENGINEER
KAMAL B MOUCHAWAR
NO. C051050
Exp. 9/30/05
CIVIL
STATE OF CALIFORNIA

CONFIDENTIALITY STATEMENT:
THE RECIPIENT OF THESE MATERIALS UNDERSTANDS THAT THE CONTENT OF THE MATERIALS IS OWNED BY BP, AND ALSO, THAT THE MATERIALS CONTAIN PRIVILEGED AND CONFIDENTIAL BUSINESS INFORMATION OF BP. ACCORDINGLY, THE RECIPIENT AGREES TO RETAIN THESE MATERIALS IN STRICT CONFIDENCE AND AGREES NOT TO DISCLOSE THESE MATERIALS TO ANYONE OTHER THAN THOSE PERSONS WHO ARE NOT TO MAKE COPIES OF THE MATERIALS. THE RECIPIENT AGREES TO USE THE MATERIALS ONLY FOR THE LIMITED PURPOSE FOR WHICH BP HAS MADE THE MATERIALS AVAILABLE, AND RECIPIENT AGREES TO RETURN ALL MATERIALS TO BP UPON COMPLETION OF THE LIMITED INTENDED PURPOSE OR UPON THE REQUEST OF BP, WHICHEVER COMES FIRST.

DEVELOPMENT INFORMATION:

NEW BUILD (STICK)
3600 SERIES AM/PM CENTER CASHIER TO GO DELI

SITE ADDRESS:

23261 CAJALCO EXWY.
@ HARVILL AVENUE
PERRIS, California 92571

-

DESIGNED BY:	-	ALLIANCE Z&DM:	-
CHECKED BY:	-	BP REPM:	-
DRAWN BY:	-	ALLIANCE PM:	-
VERSION: V01 11.17.03		PROJECT NO: E75403	

DRAWING TITLE:

BUILDING # 1 FLOOR FINISH PLAN

SHEET NO:

DOFO A.1.2b